


AS-BUILT

4,098 U.S.F.

4,713 R.S.F.

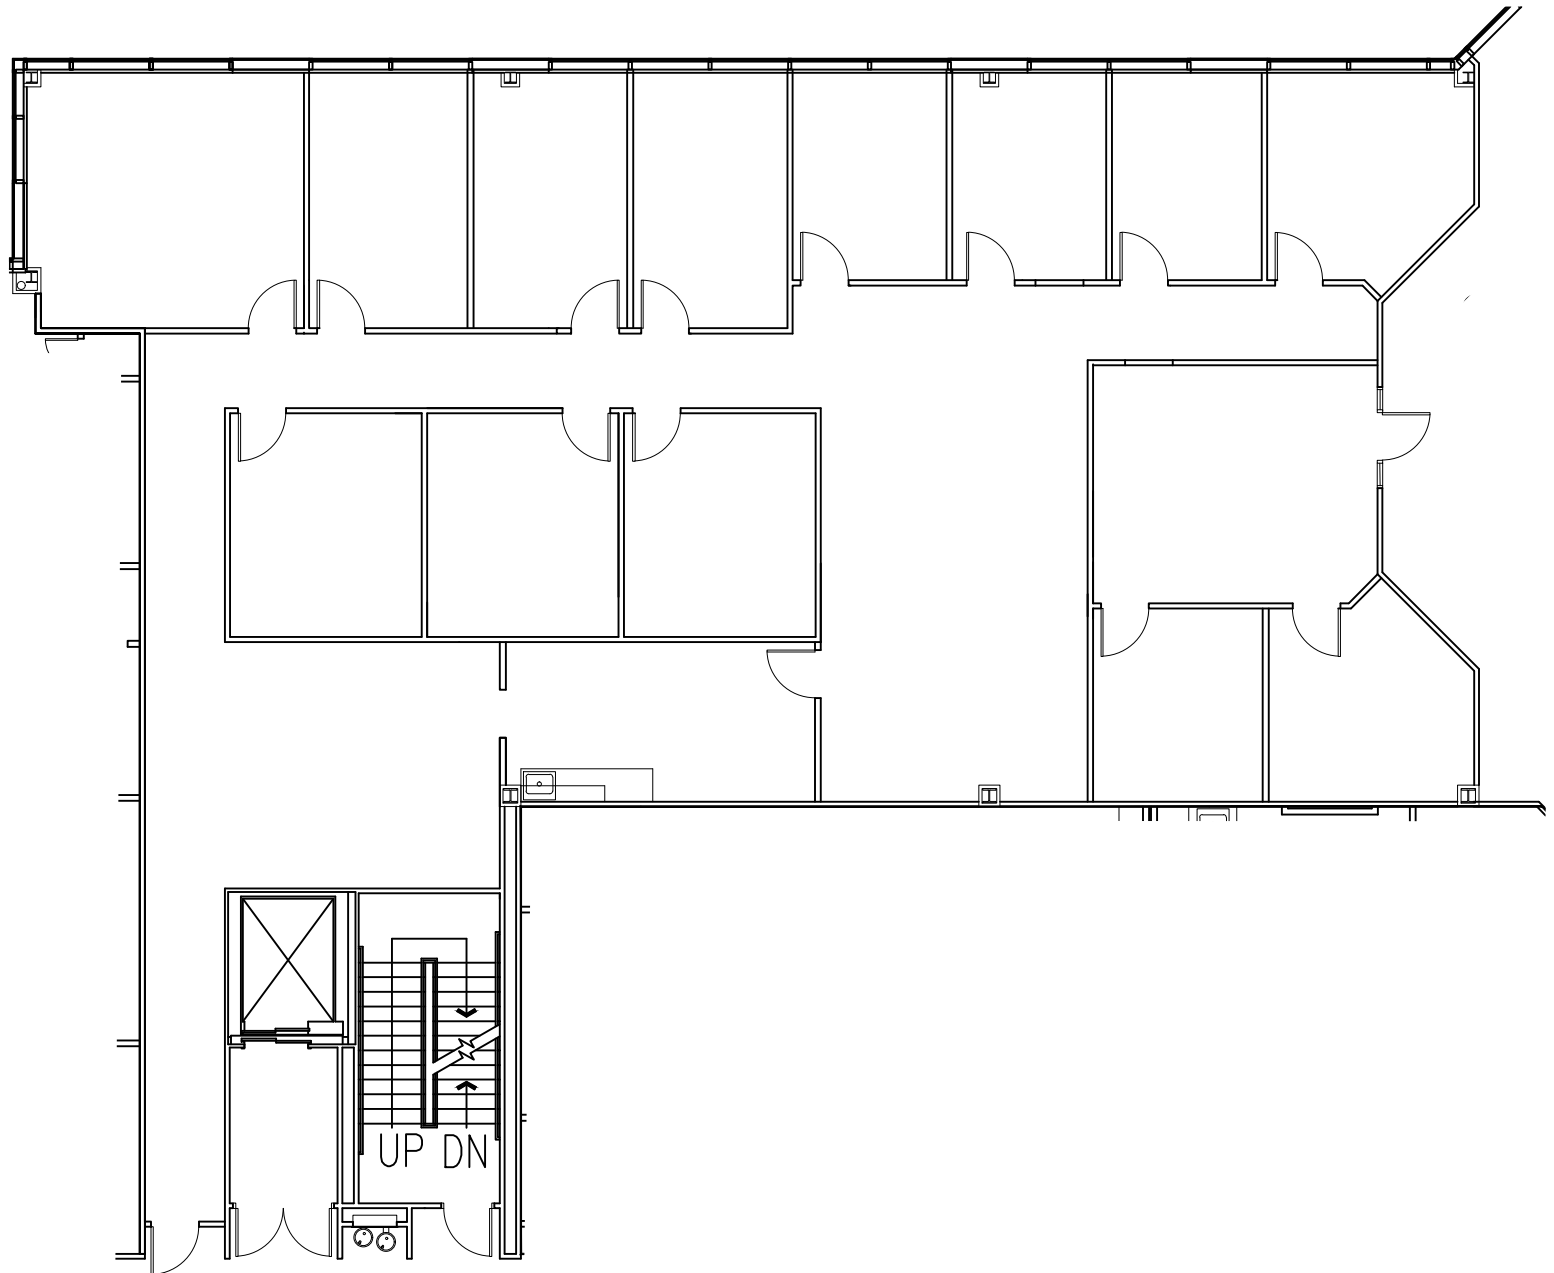

DATE: 05/21/2025

STONY POINT II - SUITE 100

9020 STONY POINT PARKWAY
RICHMOND, VA
Project No.: 9887-FL1.DWG