


AS BUILT

7,289 U.S.F.
8,382 R.S.F.

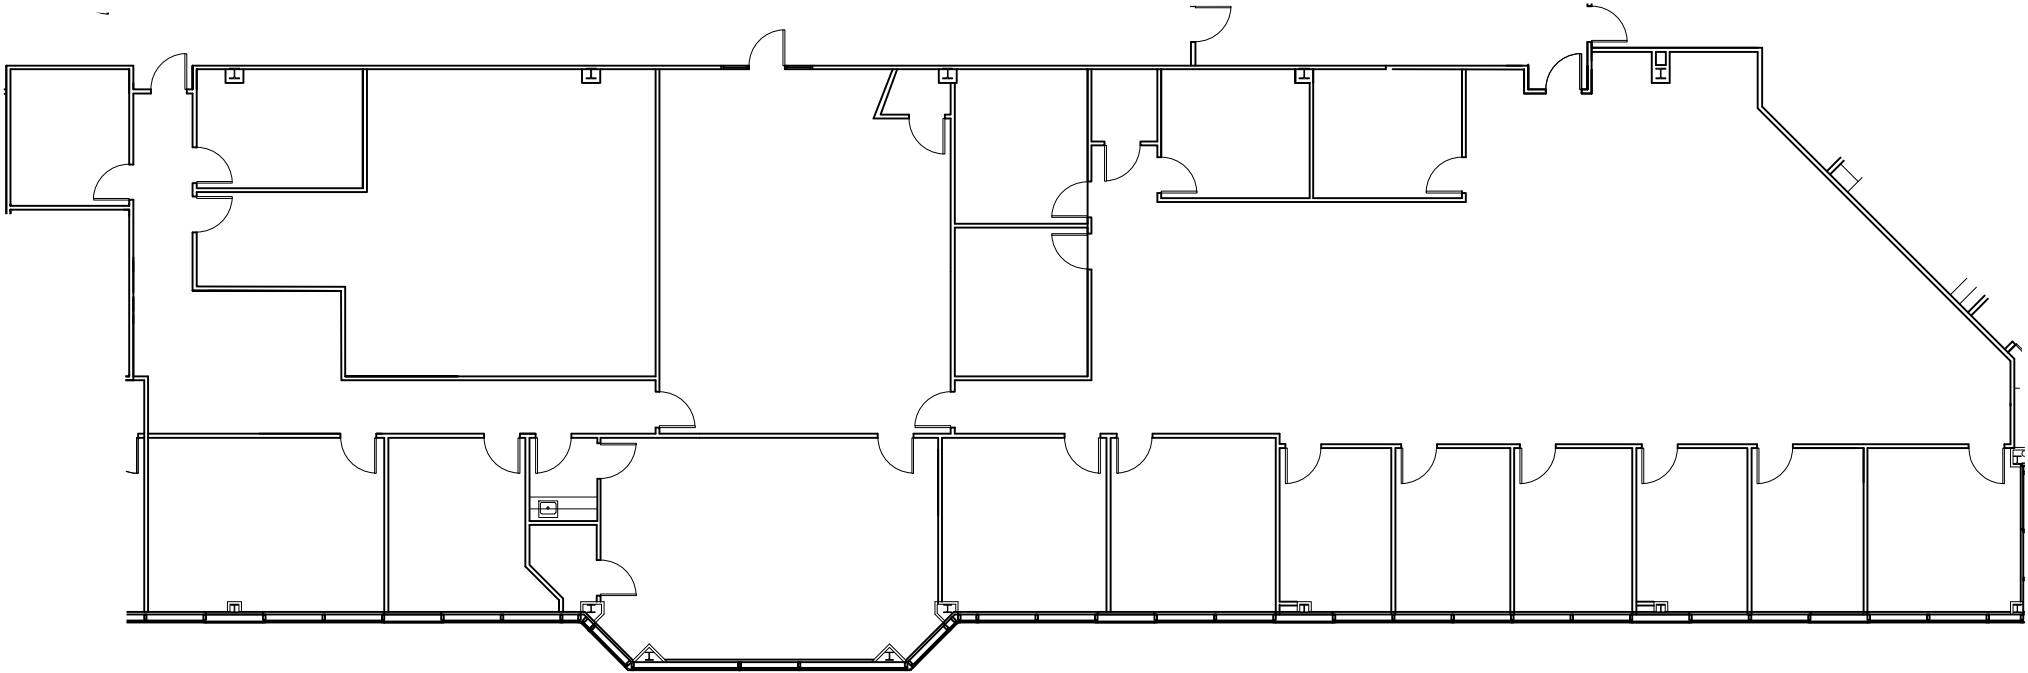

DATE: 05/21/2025

STONY POINT II, SUITE 200

9020 STONY POINT PARKWAY
RICHMOND, VA
Project No.: XXXXXX


www.wendelcompanies.com