


AS-BUILT

7,581 U.S.F.

8,718 R.S.F.

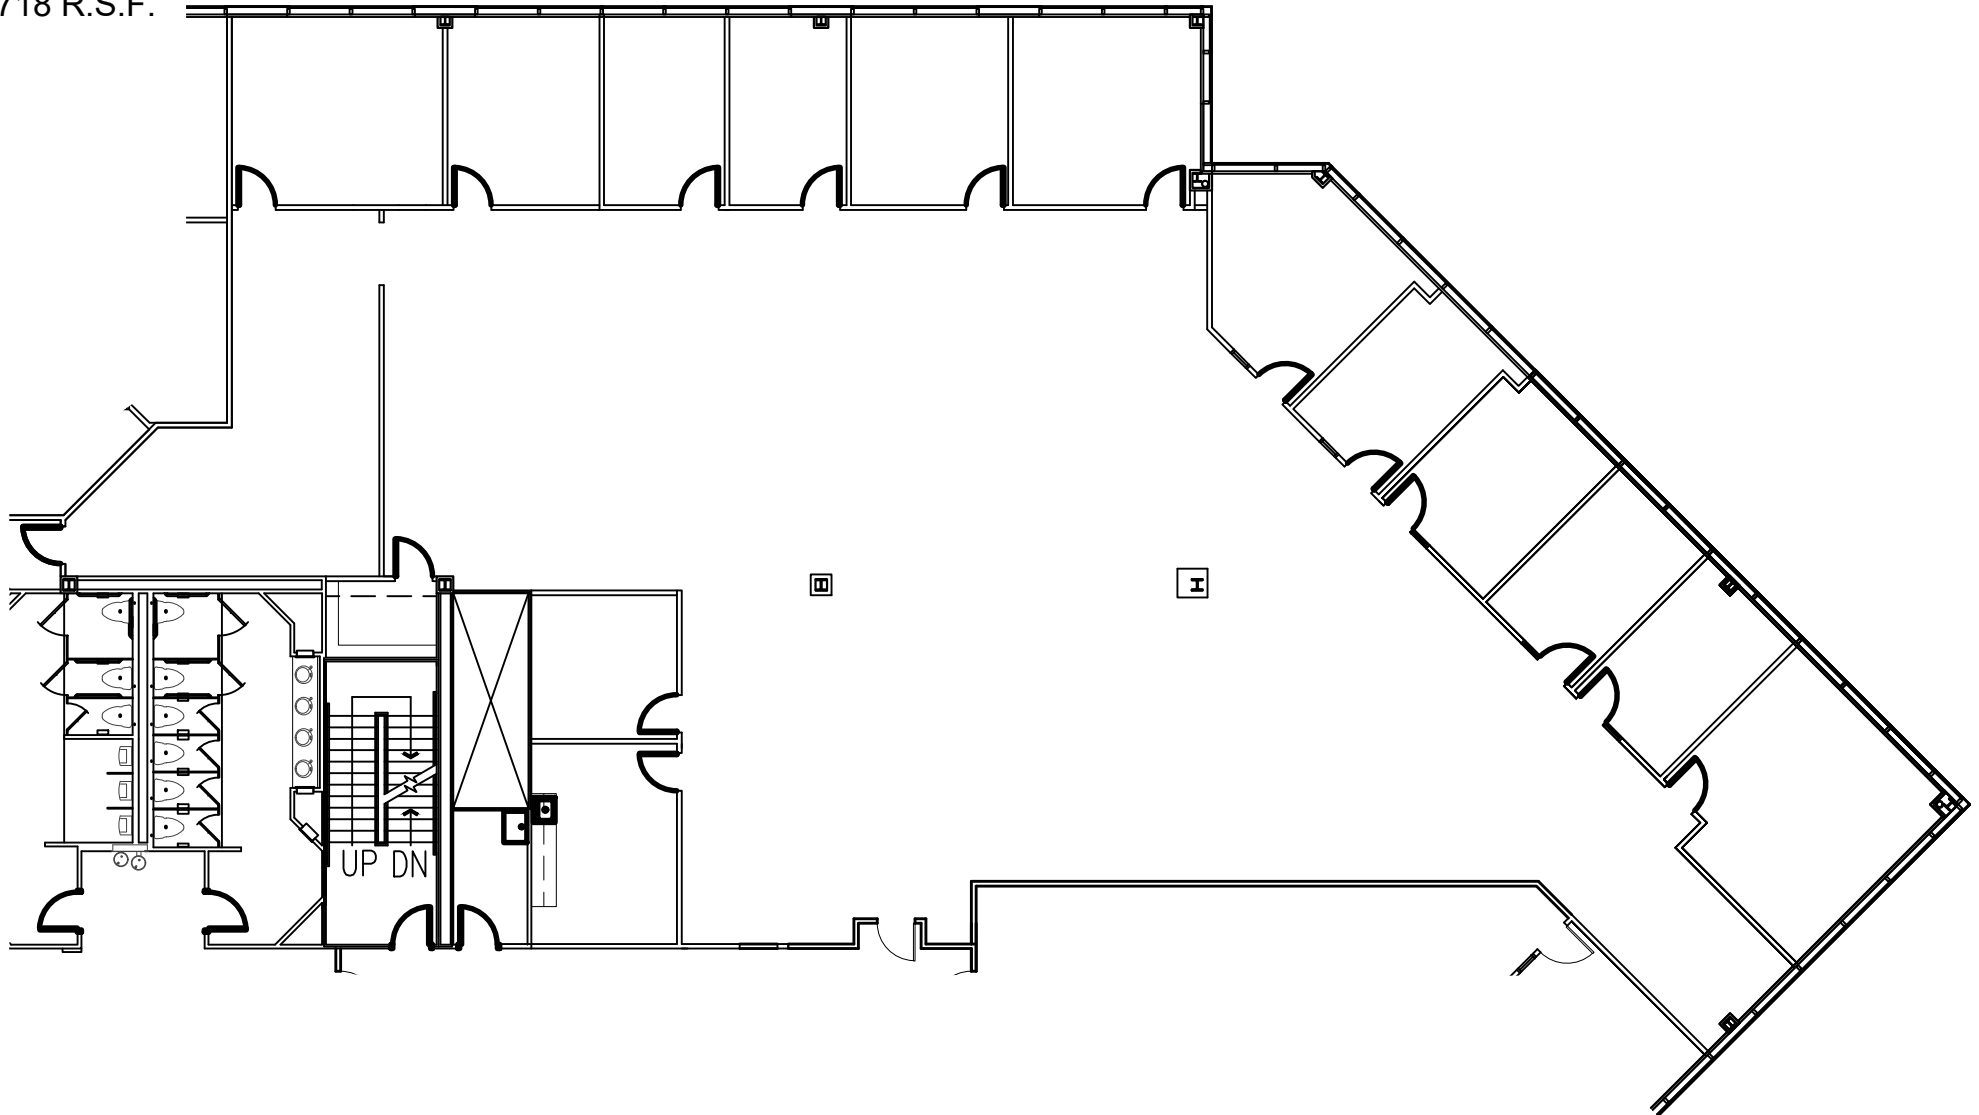

DATE: 07/03/2025

STONY POINT II - SUITE 350

9020 STONY POINT PARKWAY
RICHMOND, VA
Project No.: 9887-FL3.DWG