


# AS-BUILT

1,396 U.S.F.

1,605 R.S.F.

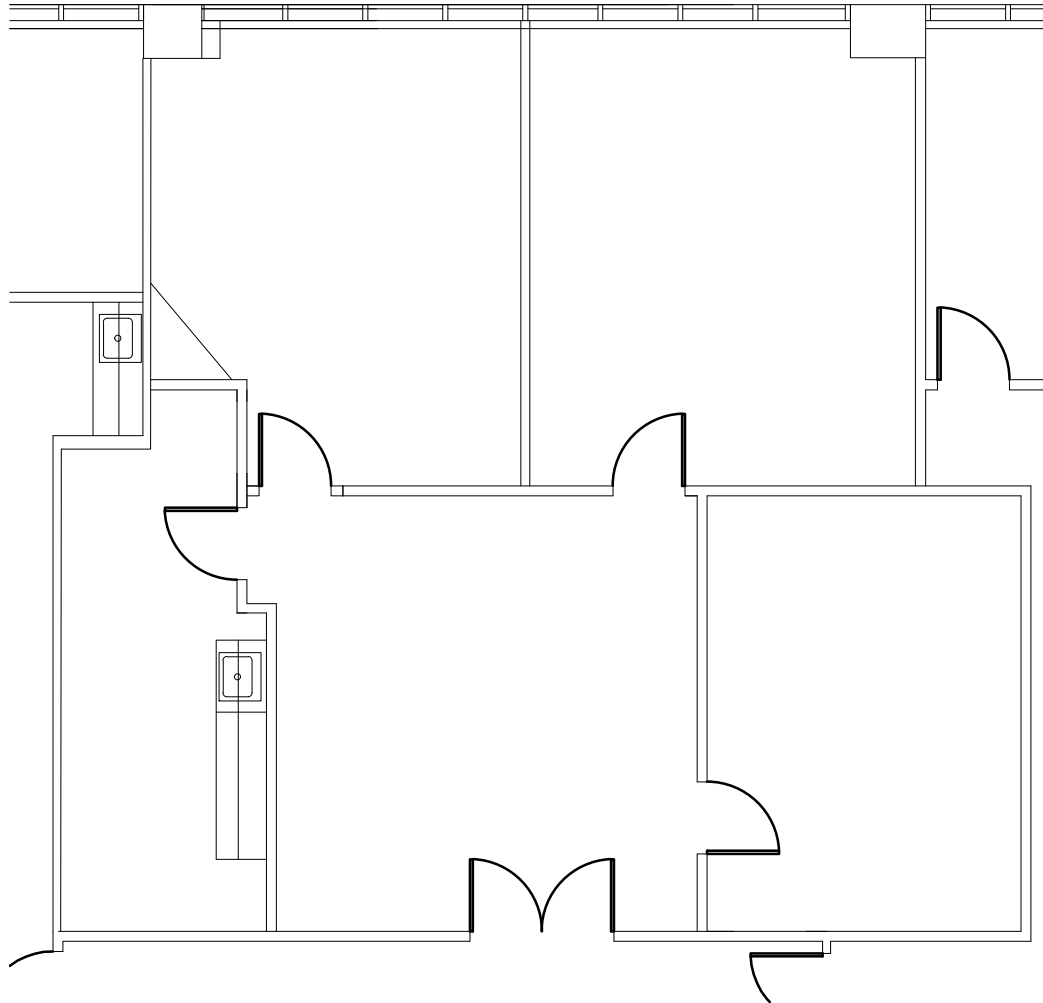

DATE: 07/03/2025

STONY POINT I - SUITE 500

9030 STONY POINT PARKWAY  
RICHMOND, VA  
Project No.: 9814-FL5.DWG