


# AS BUILT

3,298 USF

3,792 RSF

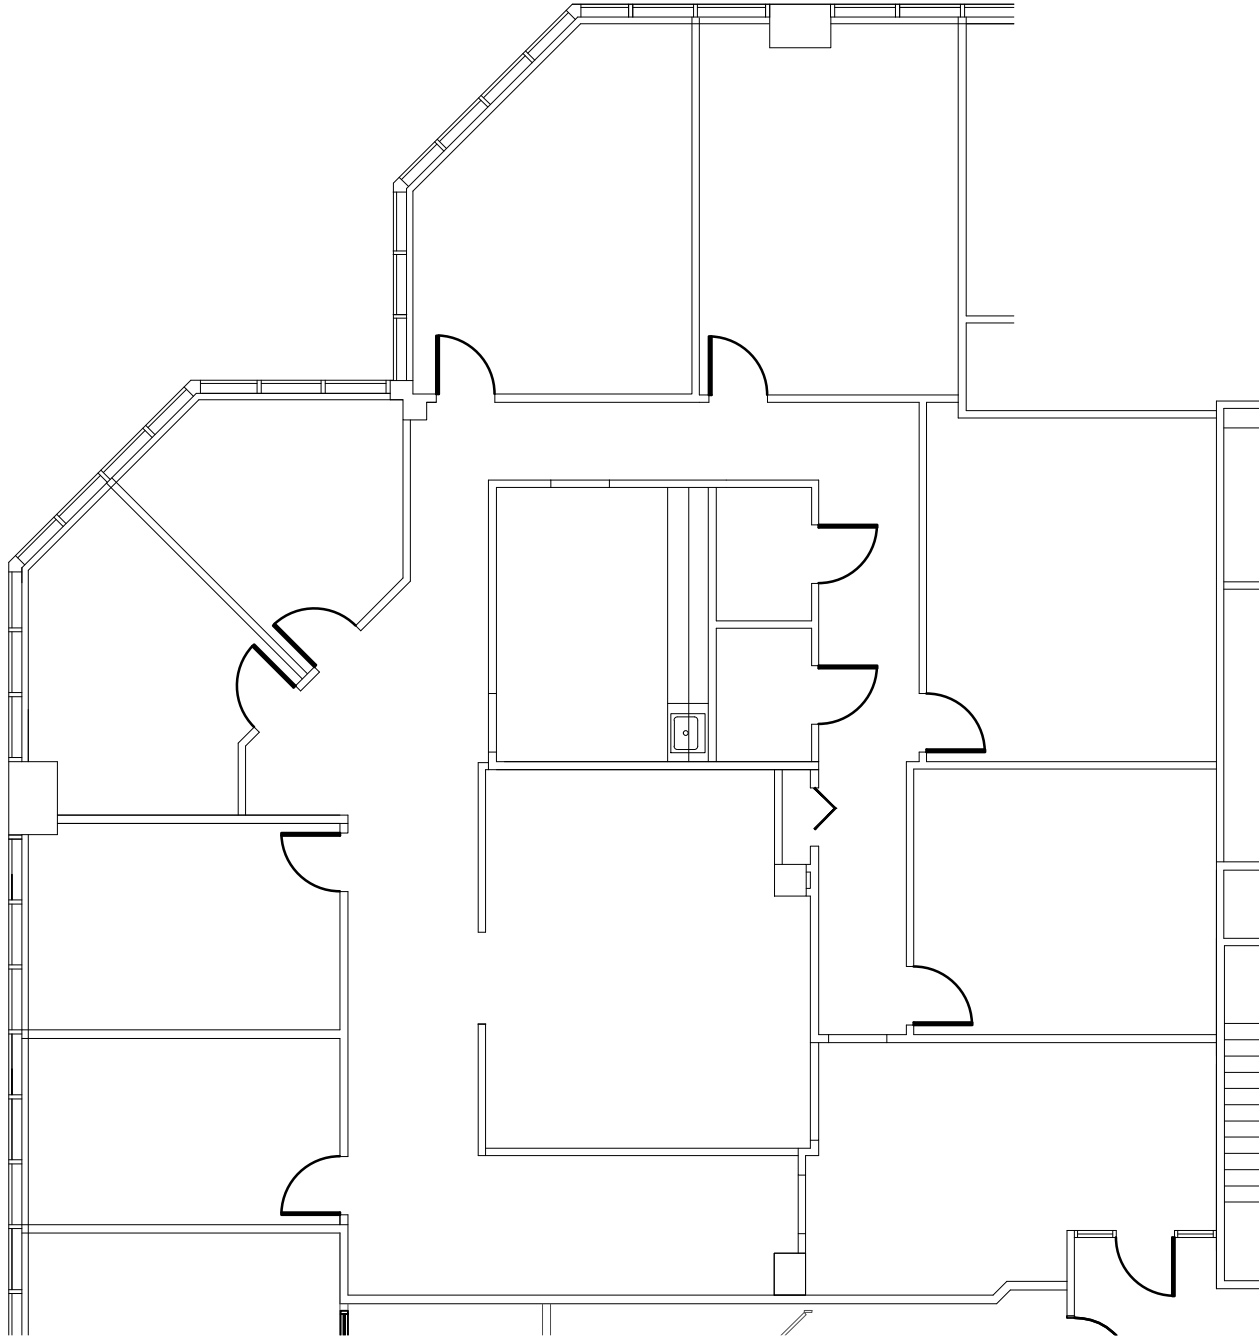

DATE: 07/03/2025

STONY POINT I- SUITE 580

9030 STONY POINT PARKWAY  
RICHMOND, VA  
Project No.: XXXXXX