
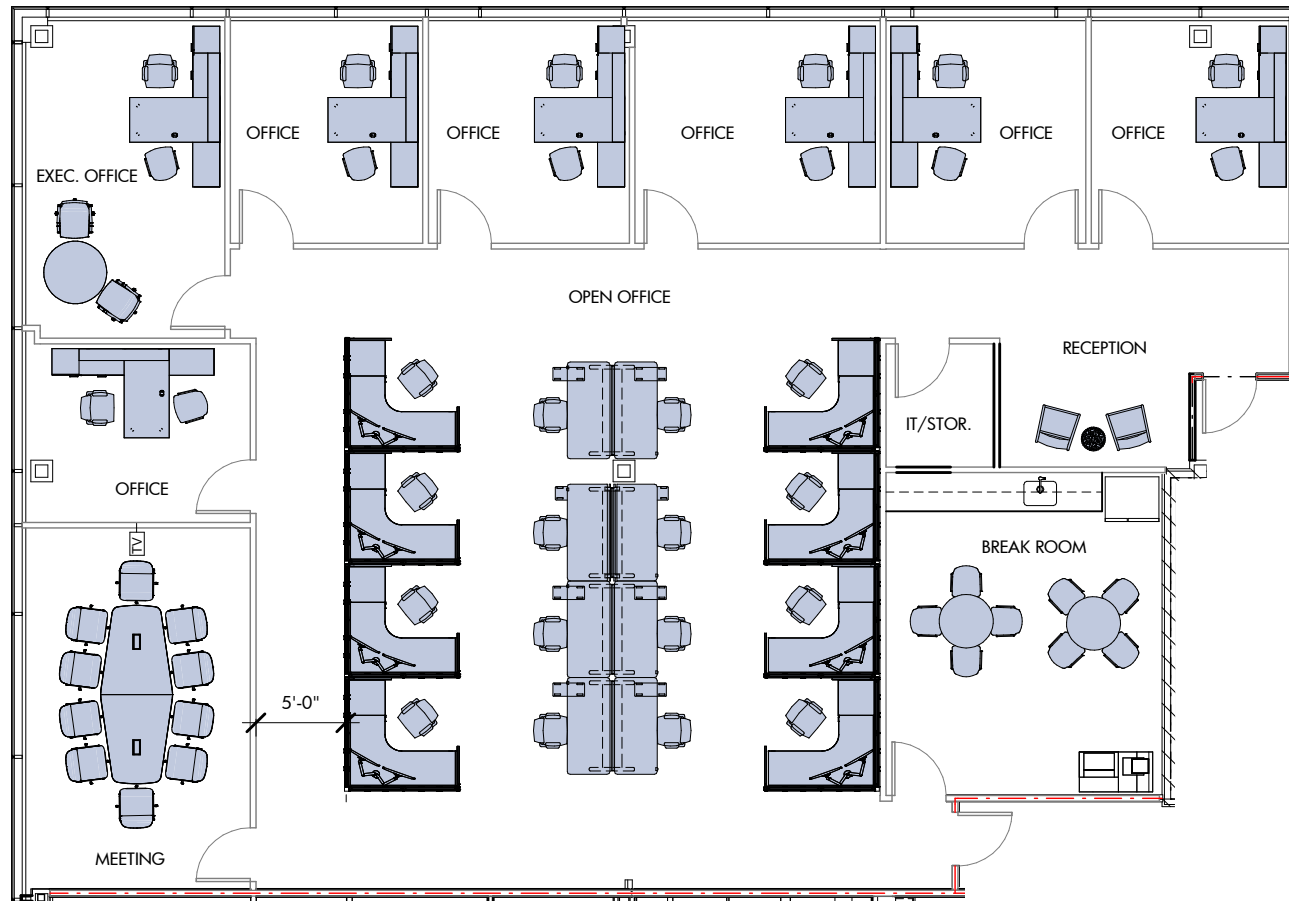


SIX FORKS CENTER I

4700 Six Forks Road | Raleigh

Suite 350 | 3,668 RSF

sample layout


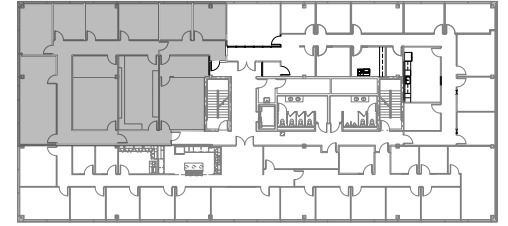


Disclaimer: The above floor plan is not to scale. The available space shown is believed to be correct but is subject to change.

SIX FORKS CENTER I

4700 Six Forks Road | Raleigh

Suite 350 | 3,668 RSF

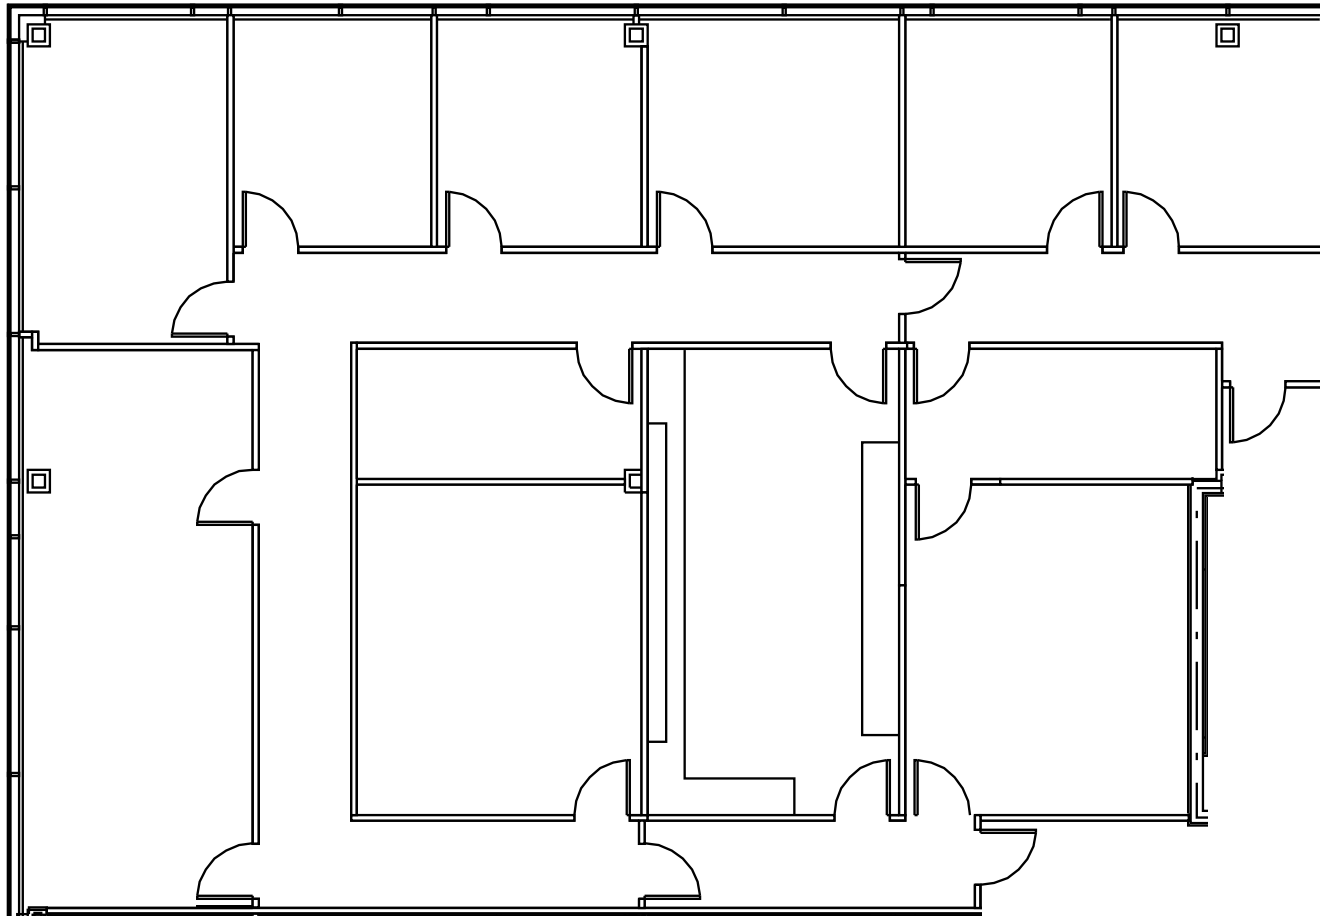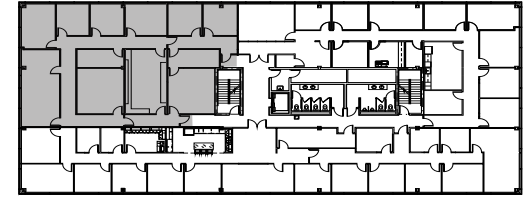

Disclaimer: The above floor plan is not to scale. The available space shown is believed to be correct but is subject to change.

GINNY HAGER | 919-875-6664
GINNY.HAGER@HIGHWOODS.COM

