

This document and the ideas and design incorporated herein, as an instrument of professional service, is the property of FULL FLOOD inc. and is not to be used, in whole or in part, for any other project without the written authorization of FULL FLOOD inc. This document is not to be reproduced or modified in any way, nor shall any reproduction of this document be modified, with out prior written consent of FULL FLOOD inc. The drawings represent visual concepts and construction suggestions only. I do not represent the knowledge and advice of a licensed structural engineer. The designer does not warrant, in any way, the accuracy of the information and shall not be responsible for discrepancies between this document and the existing conditions. The designer will not assume responsibility for improper engineering, construction, handling or use of this lighting equipment.

## INSTRUMENT KEY

- Philips Vari-Lite VL1600 Profile - Ground Control
- VL2600 Ground Control
- Philips Vari-Lite VL1600 Profile
- Philips Vari-Lite VL2600 Profile
- Vari-Lite VL3000 Spot (HOUSE FIXTURE)
- Vari-Lite VL3500 Spot (HOUSE FIXTURE)
- Vari-Lite VL3500 Wash (HOUSE FIXTURE)
- Sharp Wash (HOUSE FIXTURE)
- Ayrton Diablo
- PRG 5L Wash
- TMB Solaris Flare
- Martin Rush PAR 2 RGBW
- GLP X4 Atom
- Chroma Q Color Force II 12
- Chroma Q Color Force II 72
- ETC Source 4 19 deg
- ETC Source 4 26 deg
- ETC Source 4 36 deg
- ETC Source 4 50 deg
- S4 PAR Bar 112222
- S4 PAR Bar 112255
- S4 PAR Bar 556556
- Telescoping Stirrups hanger 4-8 ft

## VENUE

RADIO CITY MUSIC HALL



LOAD-IN	SHOWDAY	SHOW #
05/30/2025	06/08/2025	2505

DESIGNER	DICKINSON/MCCARTHY
LEAD L.D.	MADIGAN STEHLI
GAFFER	CHRIS MOELLER
PROG. 1:	HARRY SANGMEISTER
PROG. 2:	CYPRESS STAELIN
LEAD TECH	MATT GENCZKO

VERSION	01. PRELIM
02.	SCENERY AND RIGGING ADJ
03.	CLEANUP AND NOTES
04.	AS BUILT



## PRINT ARCH D SHEET

DRAWN BY: TE SCALE: 1/4" = 1'-0"


CONTENTS	01. OVERHEAD
	02. SIDE LIGHT LADDERS
	03. FLOOR
	04A. FOH ARCH D
	04B. FOH ARCH E
	05. SECTION
	06. FRONT PERSPECTIVE

## SHEET #

LX-5

PUBLISH DATE: 06/08/2025

## SECTION

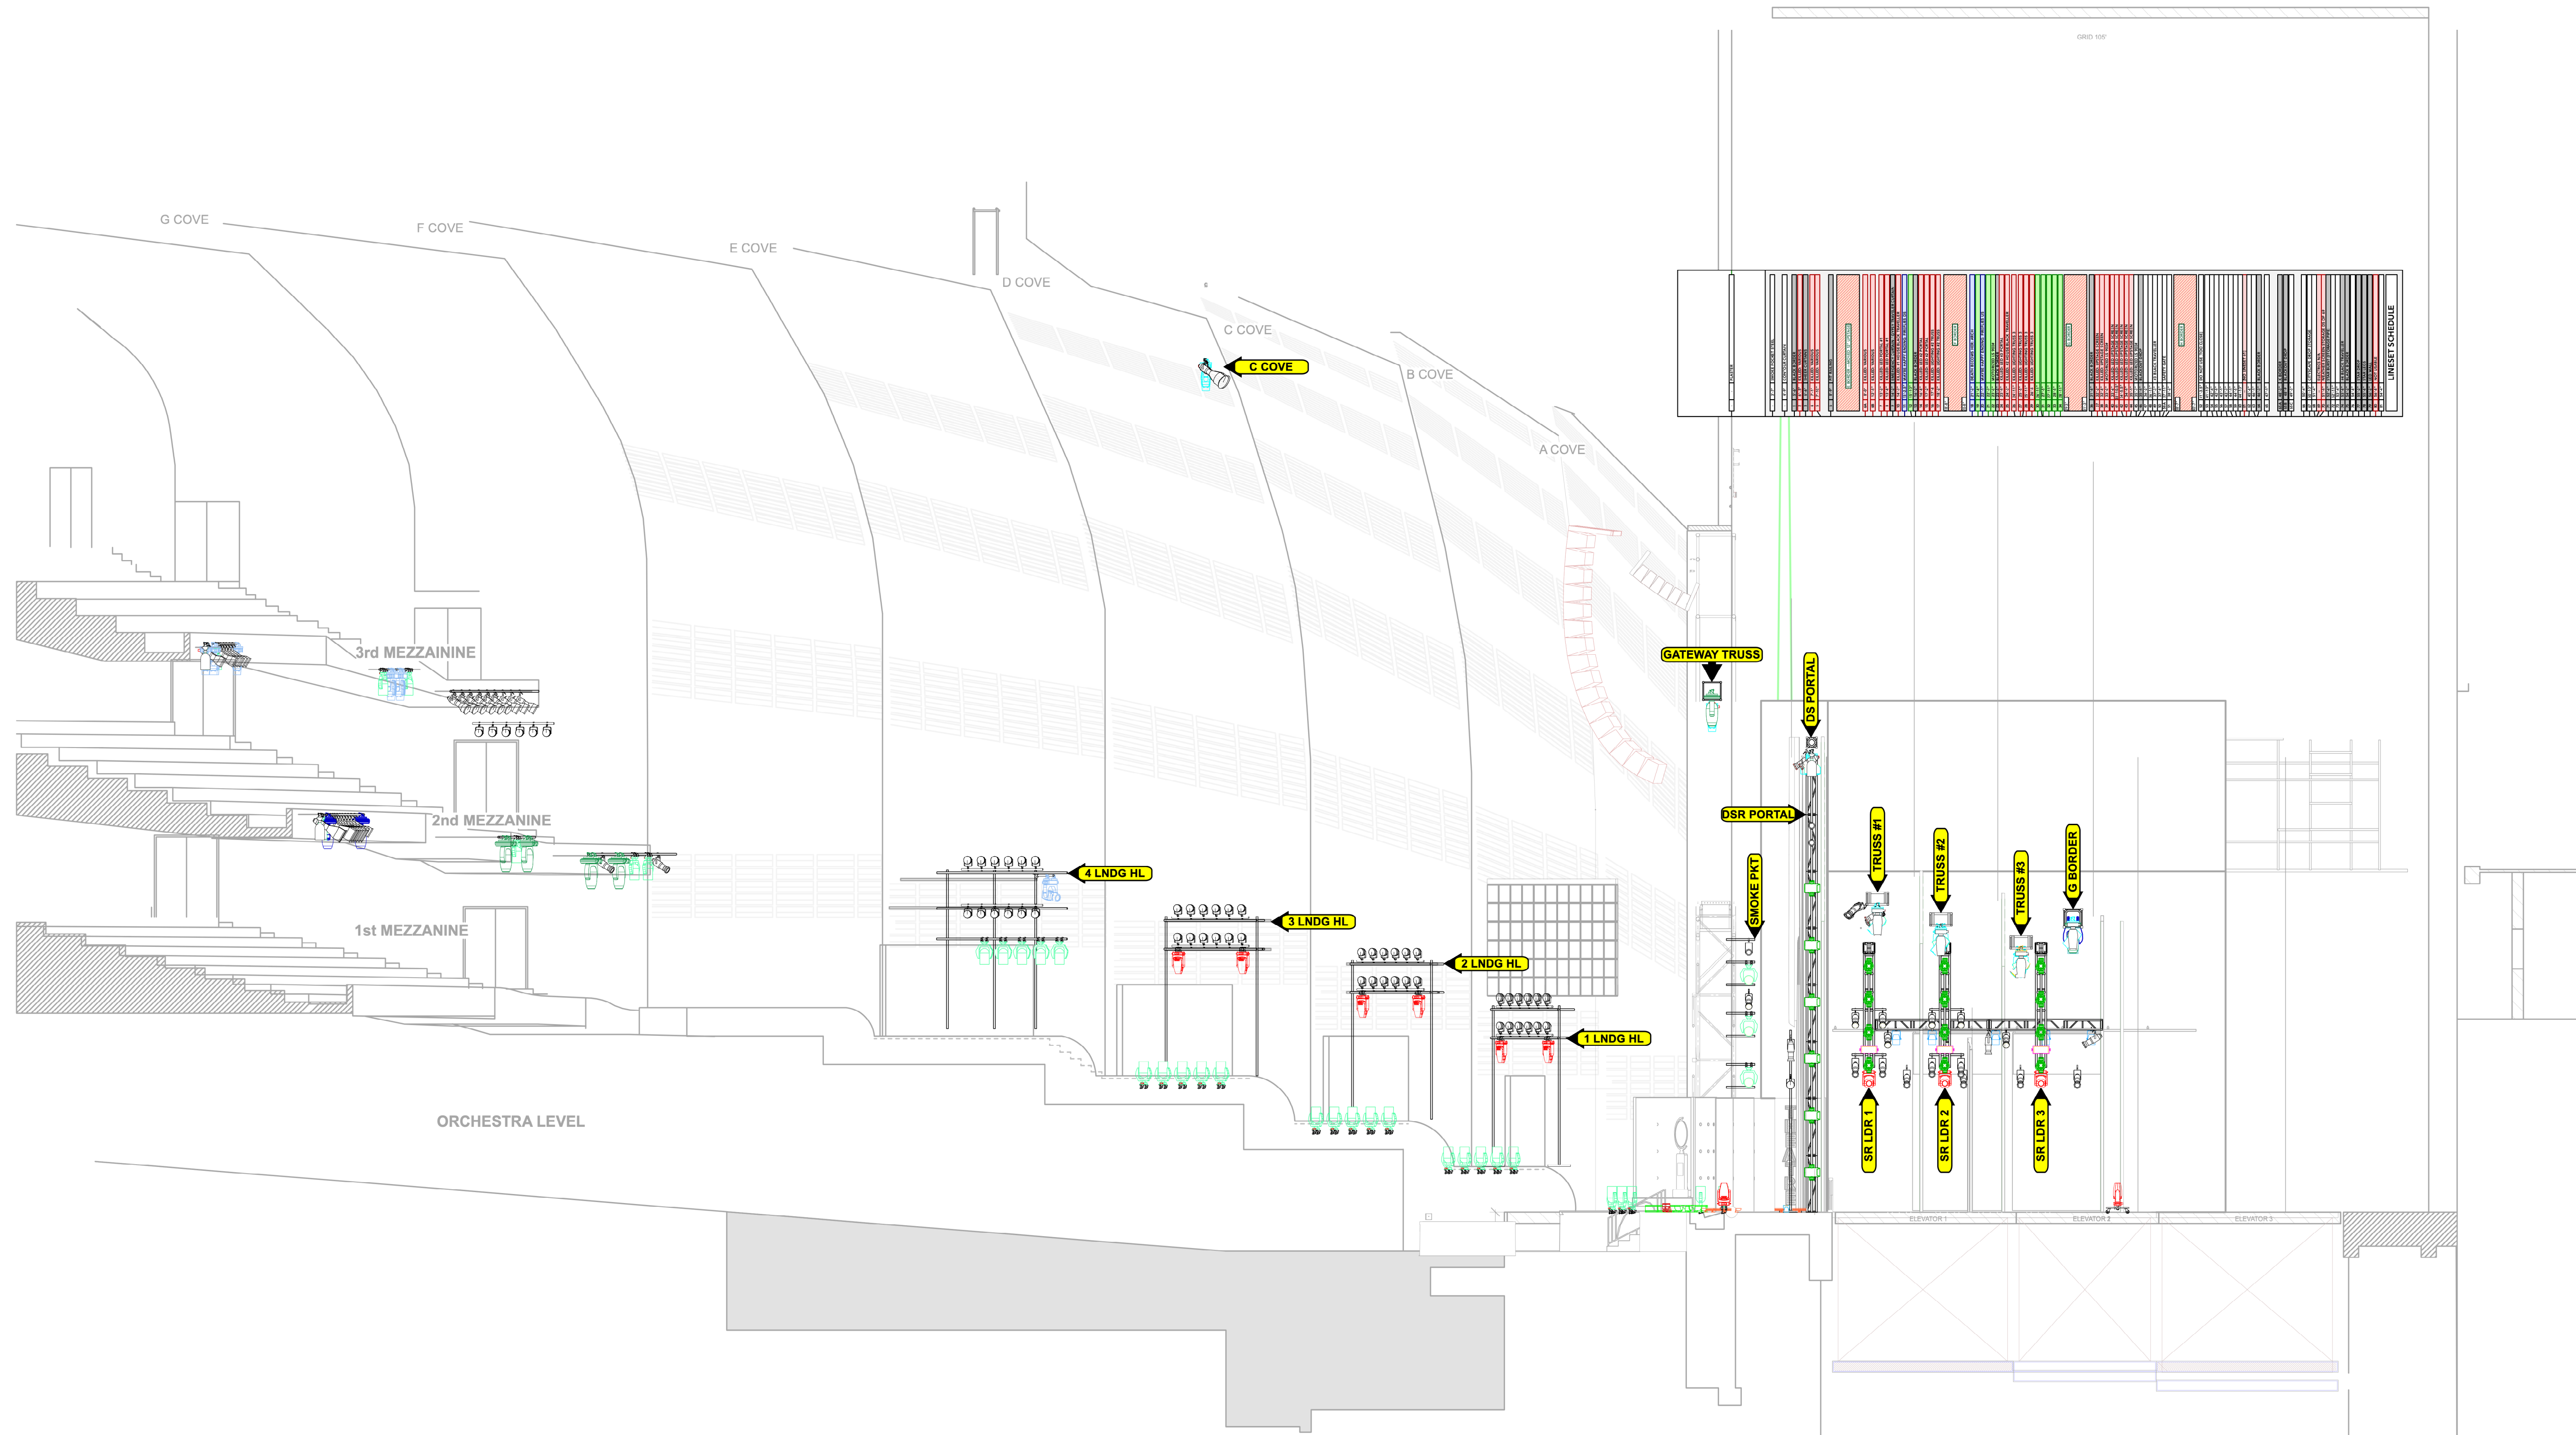

A SR SECTION  
Scale: 1/8" = 1'-0"