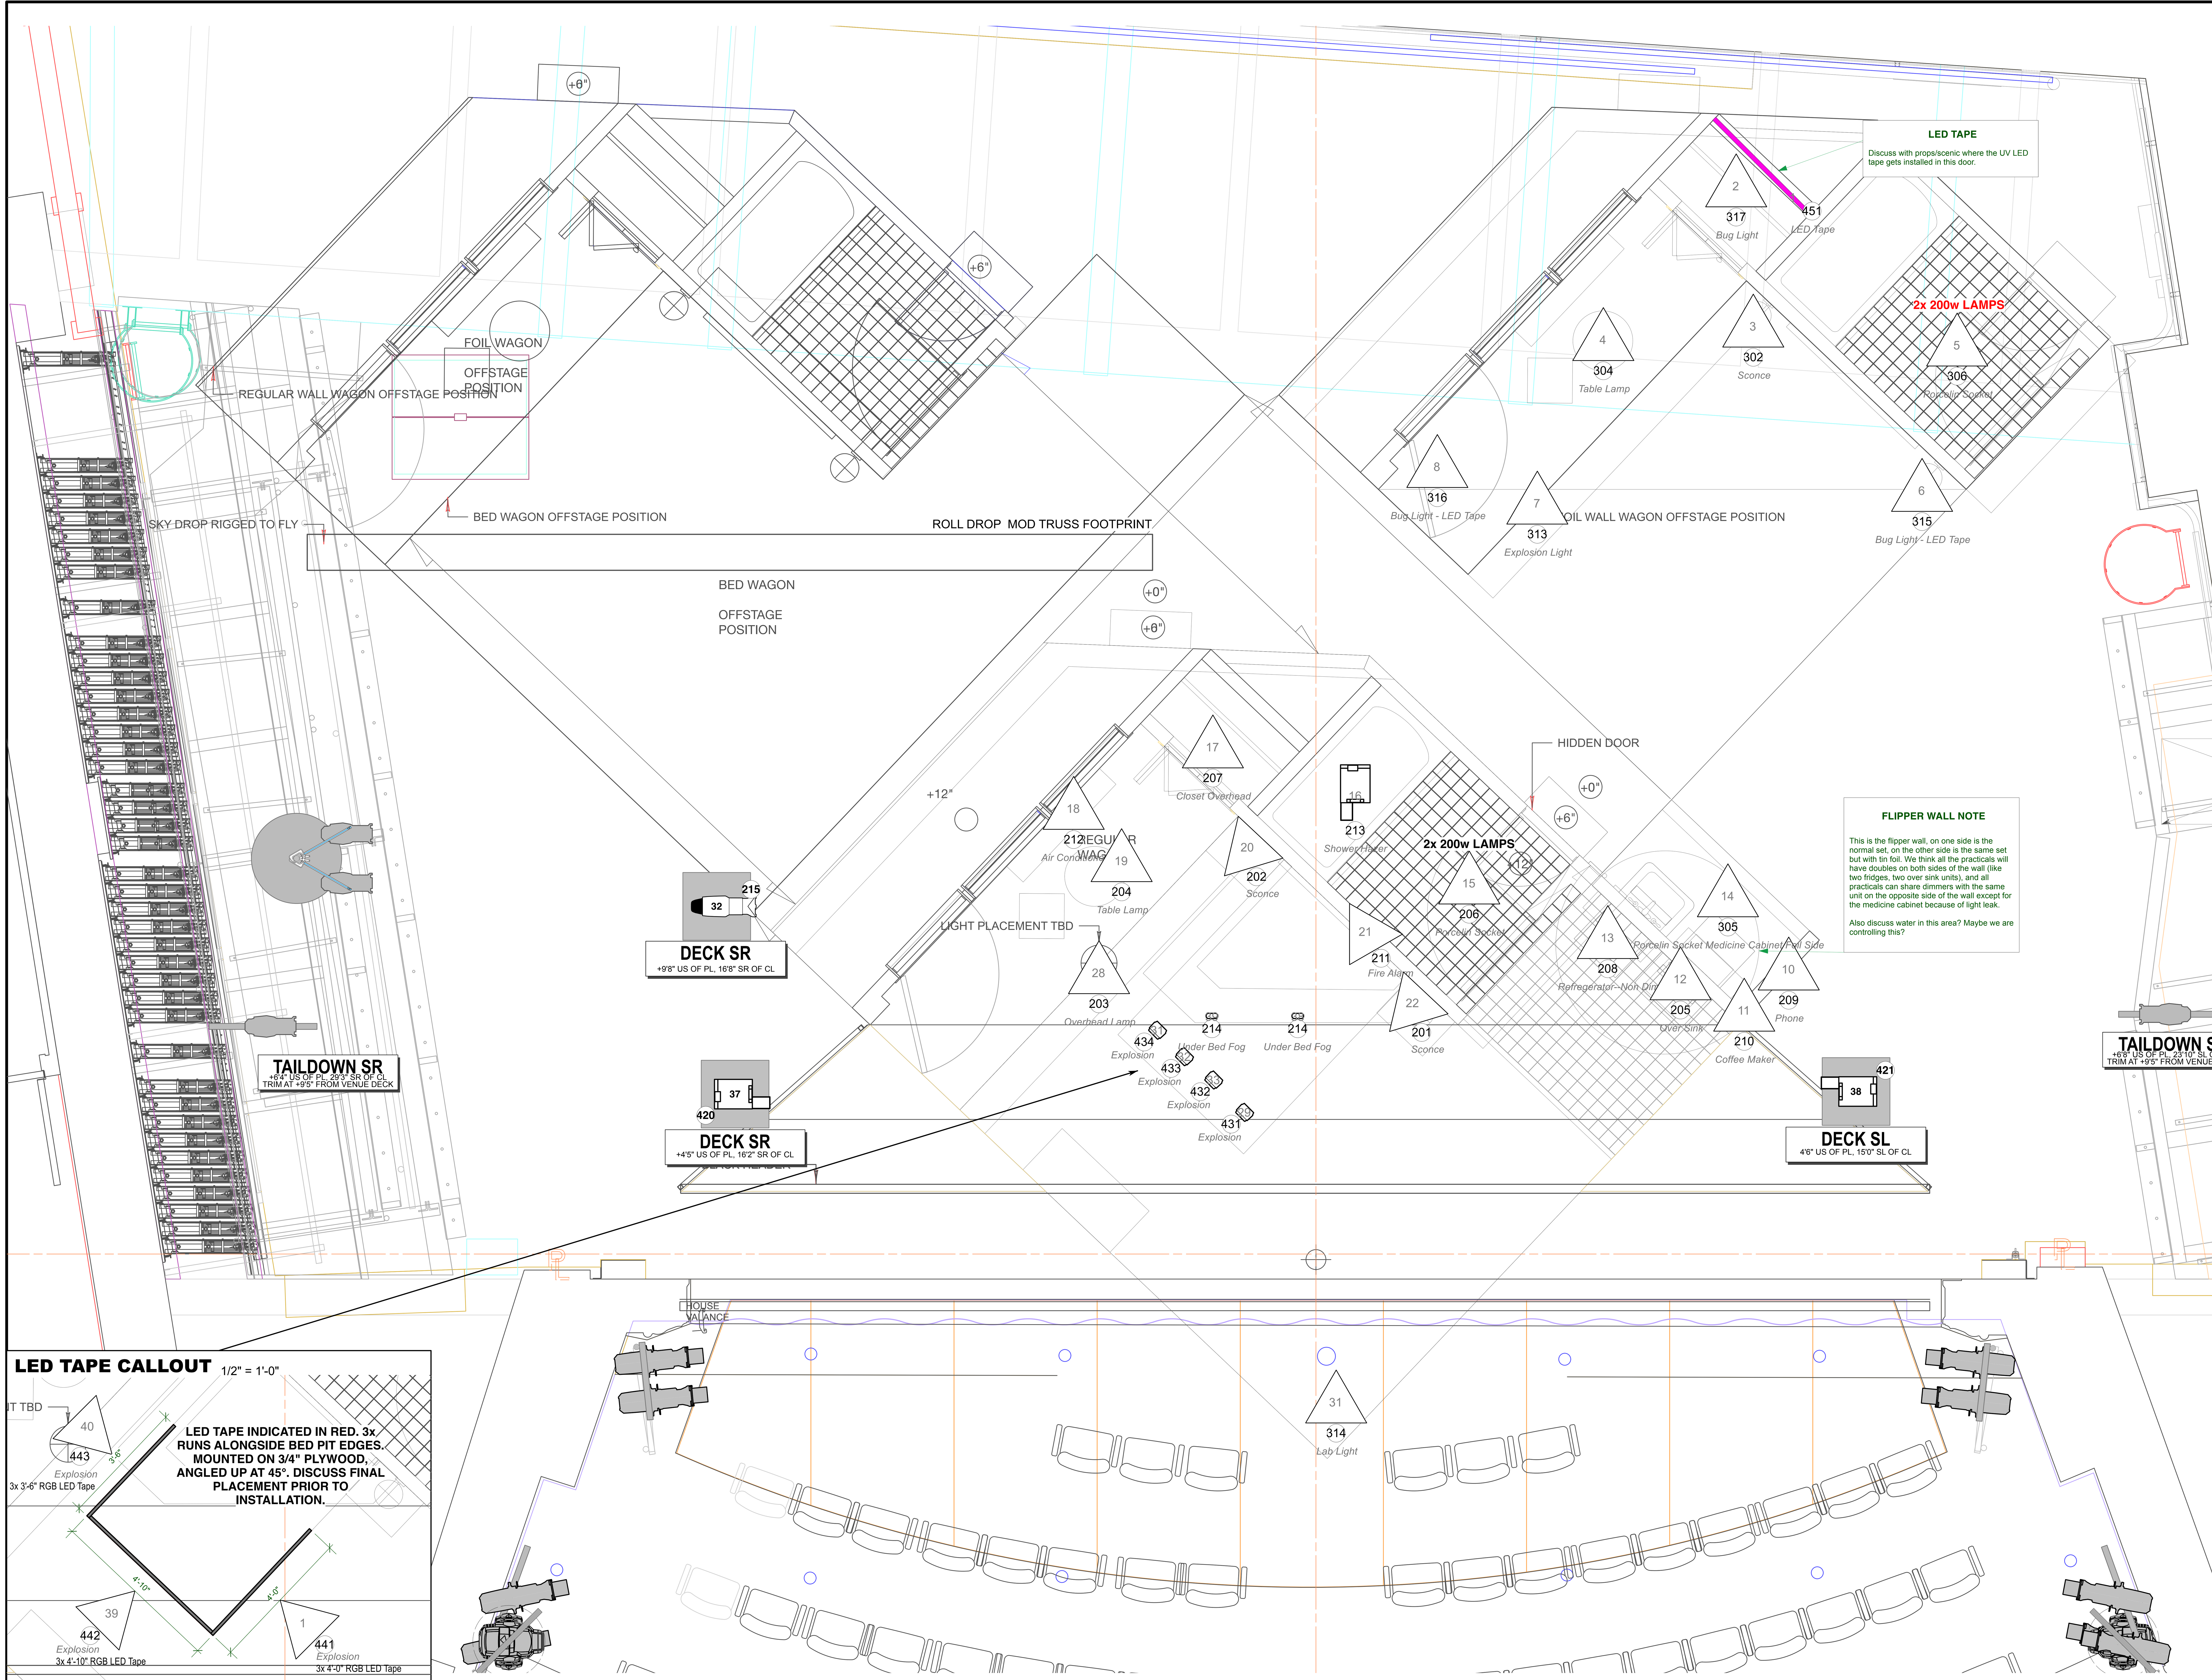

INSTRUMENT KEY

QTY

- Mac Viper XIP - 1040w
- Mac Encore WRM - 596w
- GLP Impression X5 - 710w
- S4 ERS 14 - 750w
- S4 ERS 19 - 750w
- S4 ERS 26 - 750w
- S4 ERS 36 - 750w
- ETC S4 LUSTR2 14 - 171w
- ETC S4 LUSTR2 19 - 171w
- ETC S4 LUSTR2 26 - 171w
- ETC S4 LUSTR2 36 - 171w
- ETC S4 LUSTR2 50 - 171w
- ETC S4 LUSTR3 14 - 307w
- ETC S4 LUSTR3 19 - 307w
- ETC S4 PAR VNSP - 575w
- MARTIN VDO ATOMIC DOT - 55w
- COLORFORCE II - 800w
- UNIQUE HAZER - 1500w
- PRACTICAL

DIGITAL LAND ACKNOWLEDGEMENT

INSPIRED BY ADRIENNE WONG- BEING THAT MUCH OF OUR WORK IS SHARED DIGITALLY, PLEASE TAKE A MOMENT TO CONSIDER THE LEGACY OF COLONIZATION EMBEDDED IN OUR TECHNOLOGY, STRUCTURES, AND WAYS OF PRACTICING OUR CRAFT. WE USE EQUIPMENT AND HIGH SPEED INTERNET NOT AVAILABLE IN MANY INDIGENOUS COMMUNITIES. THE TECHNOLOGY WE USE LEAVES SIGNIFICANT CARBON FOOTPRINTS, CONTRIBUTING TO LONG TERM CLIMATE CHANGES THAT DISPROPORTIONATELY AFFECT INDIGENOUS PEOPLES WORLDWIDE. THIS IS AN INVITATION TO ACKNOWLEDGE AS WELL AS TAKE RESPONSIBILITY: MAKE THE BEST USE OF THIS TIME TOGETHER, AND CONSIDER OUR ROLES IN RECONCILIATION, DECOLONIZATION, AND ALLYSHIP.

GENERAL NOTES

1. SEE LIGHTWRIGHT FOR ALL FIXTURE PROFILE, ACCESSORY, TEMPLATE, AND COLOR INFORMATION.
2. EXACT TRIMS TO BE DETERMINED BY LD AT FOCUS.
3. ALL UNITS SPACED 18" CENTER TO CENTER UNLESS OTHERWISE NOTED.
4. PLEASE PROVIDE SPARE R132, R119, R114, BLACKTAK, AND BLACKWRAP AT ALL FOCUS CALLS.
5. ALL POSITIONS VISIBLE TO AUDIENCE, PLEASE HOLD CABLE MANAGEMENT TO THE HIGHEST STANDARD.

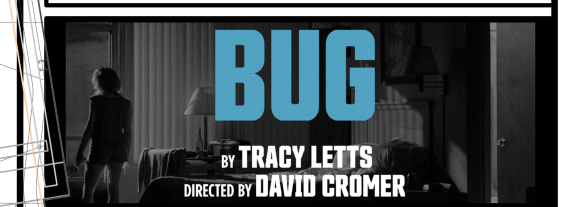

LIGHTING BY
HEATHER GILBERT
e: htglights@gmail.com | c: (312) 399-7630

ASSOCIATE DESIGNER
VICTORIA BAIN
e: victoria.a.bain@gmail.com | c: (773) 454-4652

THIS DRAWING REPRESENTS A LIGHTING DESIGN THAT IS OWNED BY HEATHERGILBERT. ANY USE OR DISTRIBUTION OF THIS DRAWING OTHER THAN AS REQUIRED FOR PRODUCTION LISTED IN THIS TITLE BLOCK IS EXPLICITLY PROHIBITED AND IS A VIOLATION OF COPYRIGHT LAWS IN THE UNITED STATES OF AMERICA AND INTERNATIONALLY. ANY UNAUTHORIZED DISTRIBUTION OR USE WILL RESULT IN LEGAL ACTION ON BEHALF OF THE DESIGNER.
THIS DRAWING AND THE LIGHTING DESIGN ITSELF ARE ©2025 HEATHER GILBERT. ALL RIGHTS RESERVED.

THIS DRAWING REPRESENTS VISUAL CONCEPTS, DESIGN IDEAS AND CONSTRUCTION SUGGESTIONS. THE DESIGNER AND THEIR DESIGN ASSOCIATES ARE ONLY RESPONSIBLE FOR THE VISUAL ASPECTS OF THE PRODUCTION AND ALL SPECIFICATIONS CONTAINED IN THIS DOCUMENT RELATE SOLELY TO THE VISUAL APPEARANCE OF THE LIGHTING DESIGN AND NOT TO THE ELECTRICAL OR STRUCTURAL SOUNDNESS AND/OR SAFETY OF THE DESIGN. THIS DRAWING DOES NOT REPLACE THE KNOWLEDGE AND ADVICE OF A LICENSED STRUCTURAL ENGINEER. THE DESIGNER IS UNQUALIFIED TO DETERMINE THE STRUCTURAL APPROPRIATENESS OF THIS DESIGN AND WILL NOT ASSUME RESPONSIBILITY FOR IMPROPER ENGINEERING, USE OR EXECUTION.

REV	TITLE	DATE
A	PRELIMINARY PLOT	10.11.2025
B	UPDATED INVENTORY	11.04.2025
C	PLOT UPDATES	12.12.2025
D	PLOT UPDATES	12.18.2025
E	SHOW FREEZE	12.30.2025

MANHATTAN THEATRE CLUB
PRESENTS

BUG

WRITTEN BY TRACY LETTS

SAMUEL J. FRIEDMAN THEATRE
261 W 47th St, New York, NY 10036

OPENING JANUARY 8, 2026

CREATIVE TEAM

DIRECTOR....................................DAVID CROMER
SCENIC DESIGNER.......................TAKESHI KADA
COSTUME DESIGNER....................SARAH LAUX
LIGHTING DESIGNER...........HEATHER GILBERT
SOUND DESIGNER........................JOSH SCHMIDT
PROD. ELECTRICIAN.................ERIK PETERSON
TECH. SUP................................STEPHEN DALTON

DECK/SET LX

SCALE: 1/4"=1'-0" 2
EXCEPT WHERE NOTED

DATE: December 30, 2025

DRAWN BY: VB